SUBSET 08 - SOUTHERN CONNECTICUT GAS
INDEX OF DRAWINGS

DRAWING NUMBER	DRAWING TITLE	DRAWING NUMBER	DRAWING TITLE
IN-01	INDEX OF DRAWINGS		
FIO-01	SOUTHERN CONNECTICUT GAS FOXON ROAD AS BUILT DRAWING		

FOR INFORMATION ONLY

REV.	DATE	REVISION DESCRIPTION	SHEET NO.

THE INFORMATION, INCLUDING ESTIMATED QUANTITIES OF WORK, SHOWN ON THESE SHEETS IS BASED ON LIMITED INVESTIGATIONS BY THE STATE AND IS IN NO WAY WARRANTED TO INDICATE THE CONDITIONS OF ACTUAL QUANTITIES OF WORK WHICH WILL BE REQUIRED.

Plotted Date: 6/22/2017

DESIGNER/DRAFTER: **MJC**

CHECKED BY:

SCALE AS NOTED

STATE OF CONNECTICUT
DEPARTMENT OF TRANSPORTATION

Filename: ..\Subset 08 Index (2).dgn

SIGNATURE/
BLOCK:

PROJECT TITLE:
REPLACEMENT OF BRIDGE NO. 01127 - FOXON ROAD (ROUTE 80) OVER FARM RIVER

TOWN: **NORTH BRANFORD**

DRAWING TITLE: **INDEX OF DRAWINGS**

PROJECT NO. **98-101**

DRAWING NO. **IN-01**

SHEET NO. **08.01**

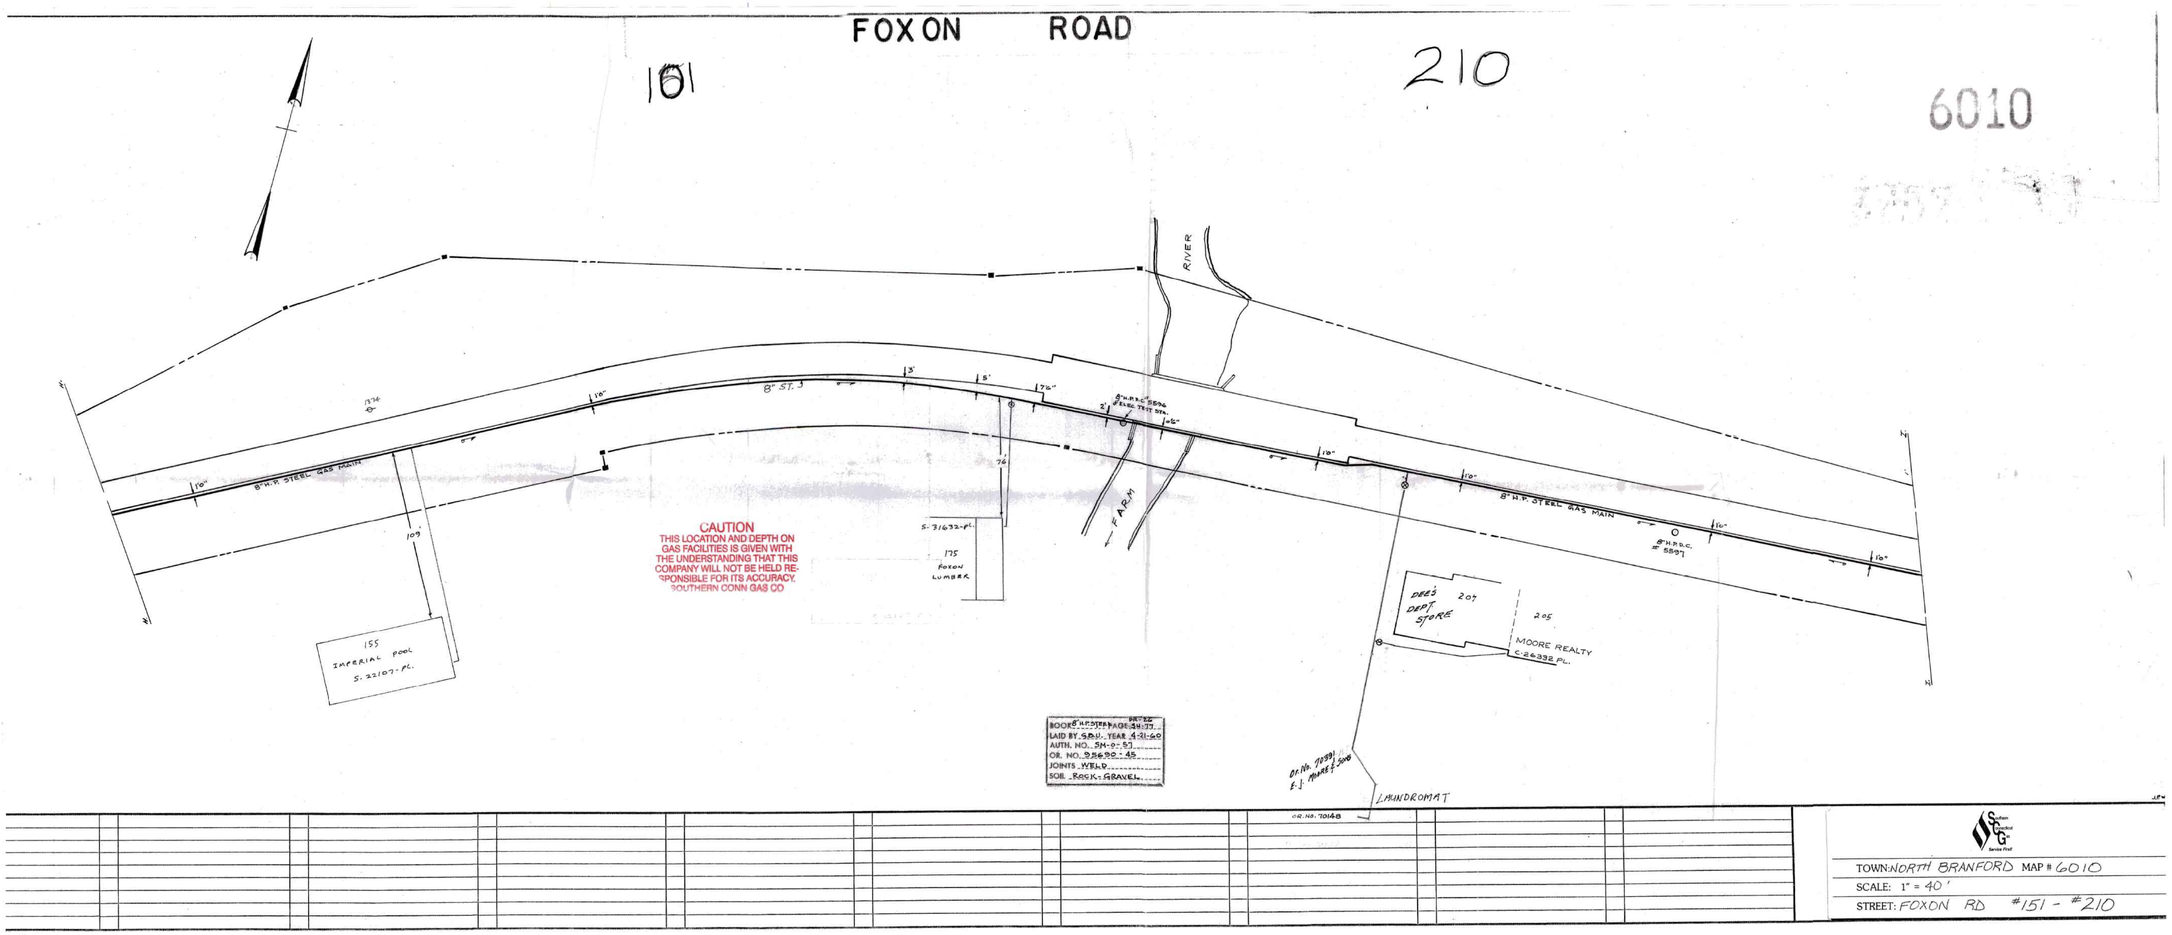

TOWN: NORTH BRANFORD MAP # 6010

SCALE: 1" = 40'

STREET: FOXON RD #151 - #210

FOR INFORMATION ONLY

REV.	DATE	REVISION DESCRIPTION	SHEET NO.

THE INFORMATION, INCLUDING ESTIMATED QUANTITIES OF WORK, SHOWN ON THESE SHEETS IS BASED ON LIMITED INVESTIGATIONS BY THE STATE AND IS IN NO WAY WARRANTED TO INDICATE THE CONDITIONS OF ACTUAL QUANTITIES OF WORK WHICH WILL BE REQUIRED.

Plotted Date: 6/22/2017

DESIGNER/DRAFTER: **MJC**

CHECKED BY:

NOT TO SCALE

STATE OF CONNECTICUT
DEPARTMENT OF TRANSPORTATION

Filename: ...\SCG_MSH_0098_0101_FIO-01.dgn

SIGNATURE/
BLOCK:

PROJECT TITLE:

REPLACEMENT OF BRIDGE NO. 01127 - FOXON ROAD (ROUTE 80) OVER FARM RIVER

TOWN: **NORTH BRANFORD**

DRAWING TITLE: **SOUTHERN CONNECTICUT GAS FOXON ROAD**

PROJECT NO. **98-101**

DRAWING NO. **FIO-01**

SHEET NO. **08.02**